Robot wiring
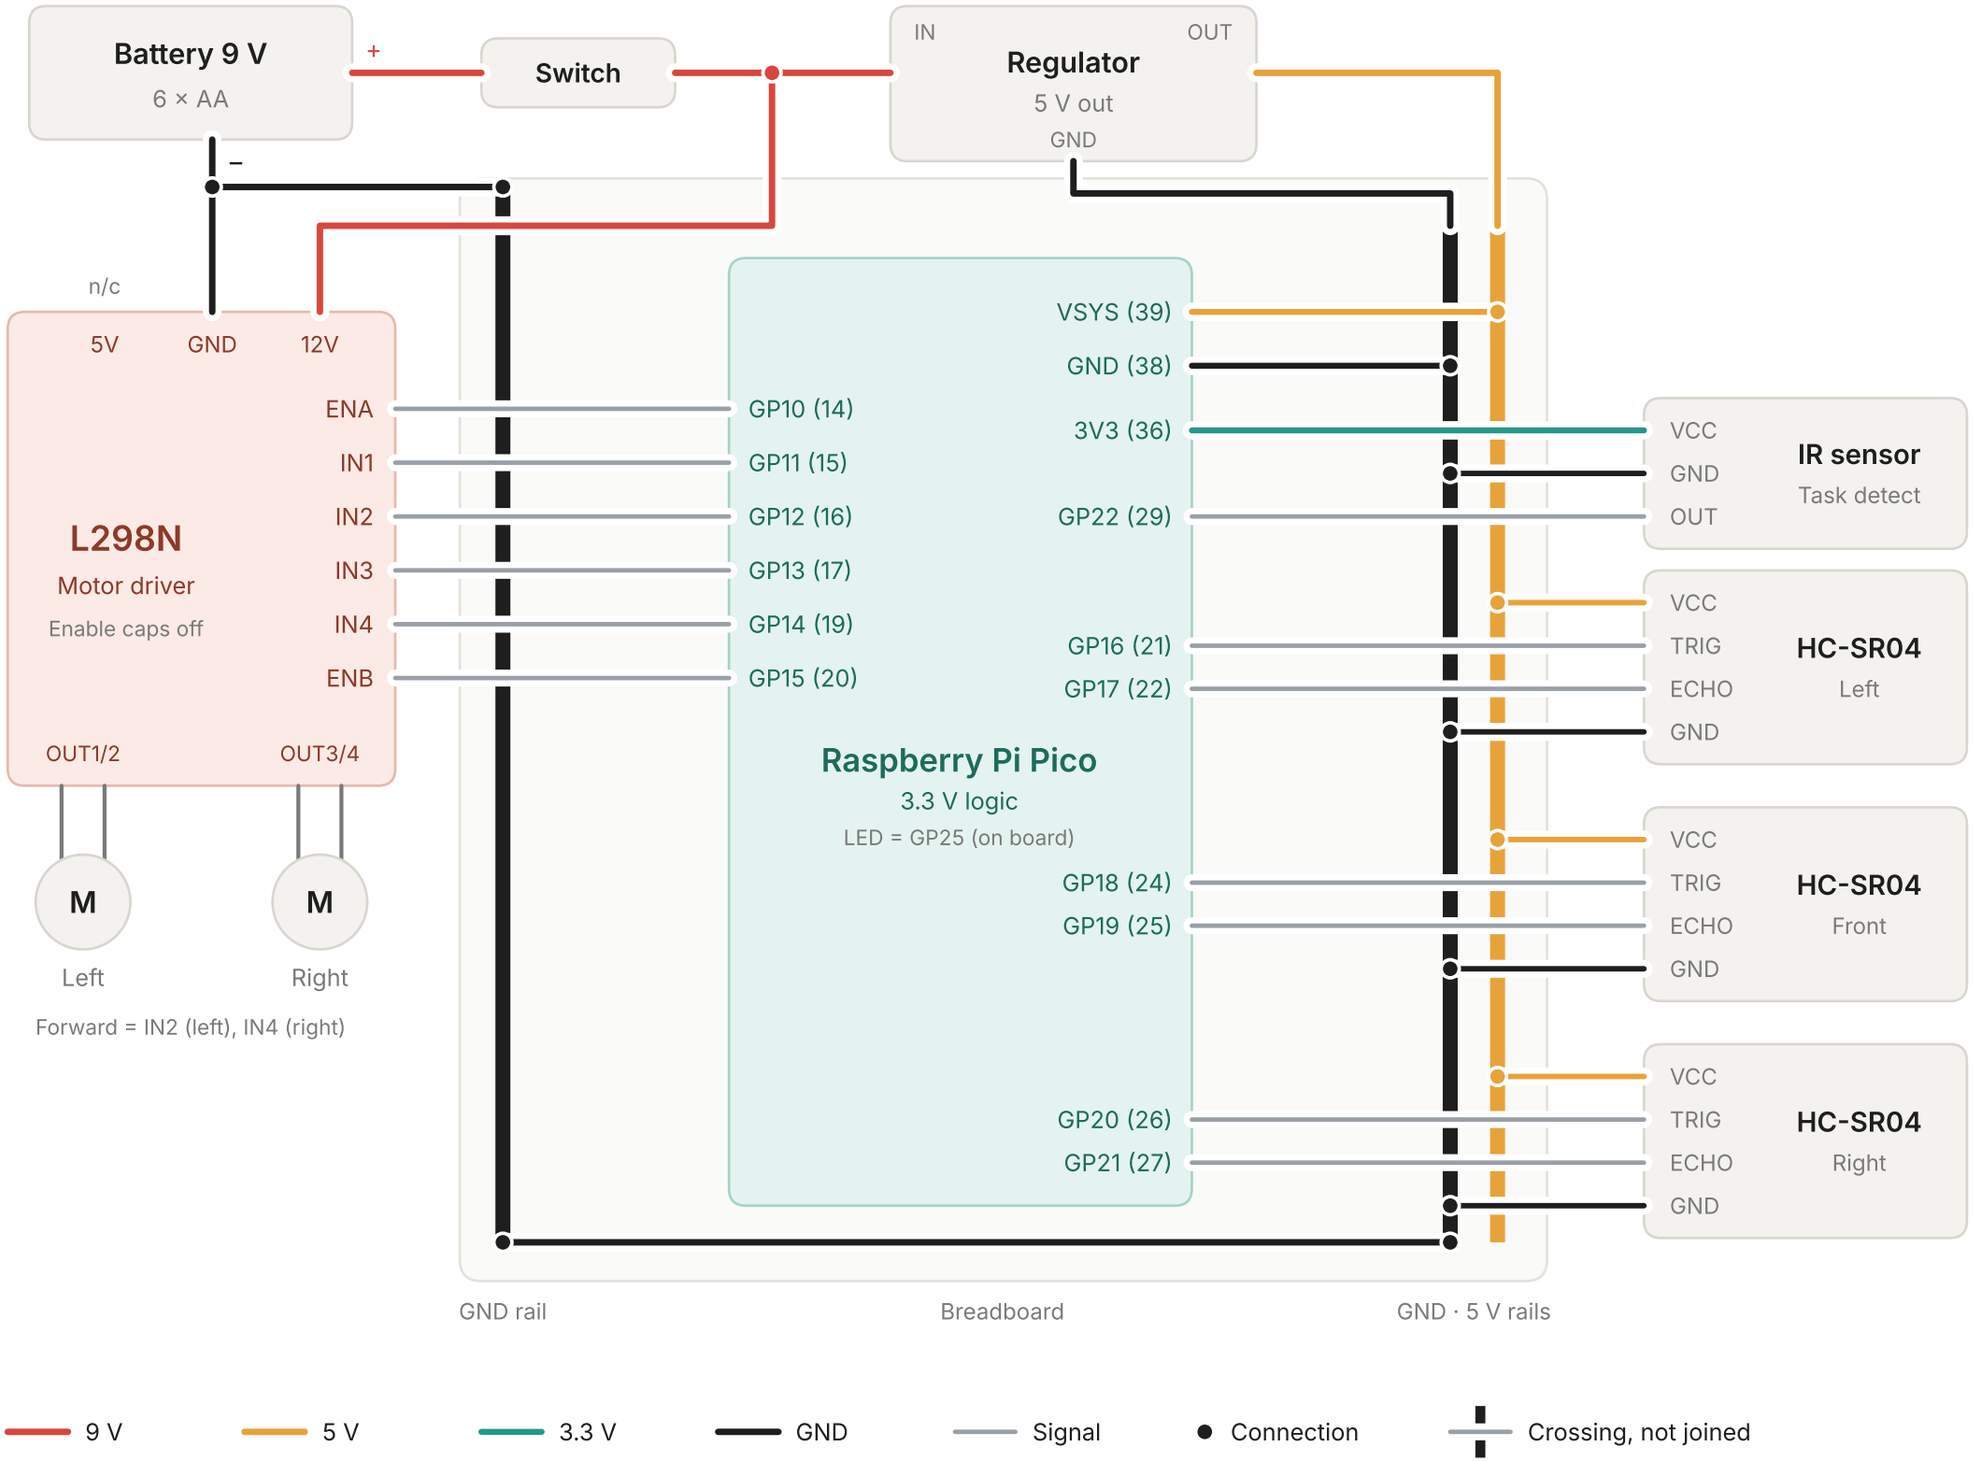
As built · Raspberry Pi Pico, L298N, 3 × HC-SR04, IR module · 11 Nov 2026